


NOTES

1. REMOVE ALL SANITARY SEWER AND VENT PIPING AND ASSOCIATED PIPE SUPPORTS IN AREA OF WORK, INCLUDING PIPING ABOVE EXISTING HARD PLASTER CEILINGS IN ROOMS B107 & B132. EXISTING DRAIN PIPING LAYOUT IS APPROXIMATE AND CONTRACTOR SHALL FIELD VERIFY ALL LOCATIONS AND QUANTITIES OF ALL EXISTING SANITARY SEWER AND VENT PIPING TO BE REMOVED WITH R.E.
2. CONTRACTOR SHALL PHASE DEMOLITION AND REPLACEMENT OF PIPING TO MINIMIZE DISRUPTION OF SERVICE TO FACILITY. NO MORE THAN ONE BATHROOM SHALL BE OUT OF SERVICE AT ANY ONE TIME IF AT ALL POSSIBLE. ALL PIPING TIE INS AND DISRUPTIONS TO INDIVIDUAL SECTIONS OF SANITARY SYSTEM AND MAIN BUILDING SANITARY SEWER SERVICE SHALL BE SCHEDULED FOR AFTER HOURS AND/OR ON WEEKENDS. CONTRACTOR SHALL PERFORM AS MUCH PREPARATORY WORK AS POSSIBLE PRIOR TO SERVICE INTERRUPTIONS IN ORDER TO MINIMIZE DURATION OF SERVICE OUTAGES DURING PIPING REMOVAL AND TIE-INS. PROVIDE WRITTEN REQUEST FOR ALL PIPING TIE-INS AND SERVICE DISRUPTION A MINIMUM OF 14 DAYS IN ADVANCE OF PROPOSED DATE. COORDINATE WITH R.E.
3. PROVIDE ADEQUATE SUPPORT FOR PERSONNEL WORKING ON TOP OF EXISTING HARDBOARD PLASTER CEILINGS AND/OR REMOVE AND REPLACE EXISTING HARDBOARD CEILINGS AS NECESSARY TO REMOVE AND REPLACE PIPING.

SYMBOLS

⊕ LIMIT OF DEMOLITION

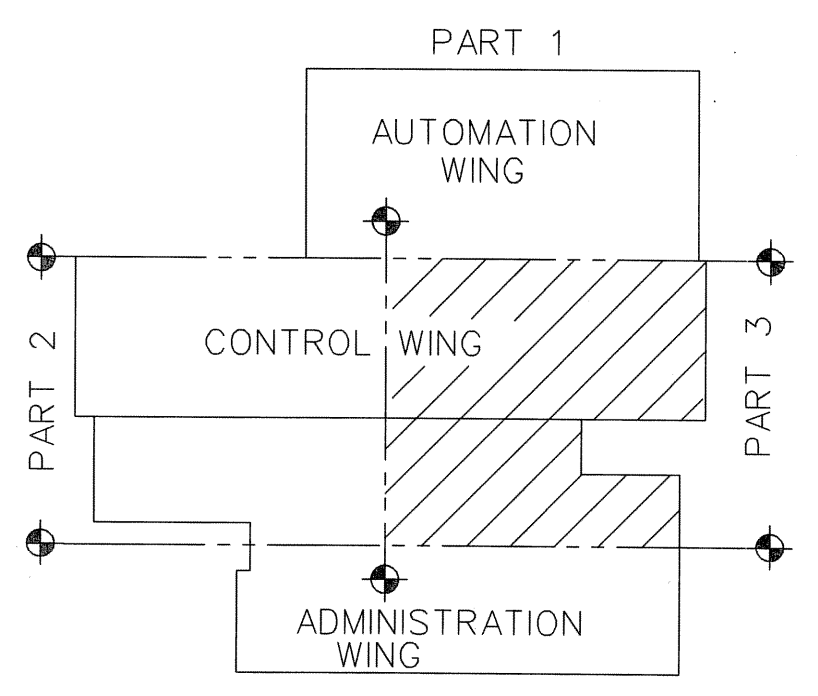

KEY PLAN

NOTE: ALL PIPING SHOWN IS ABOVE FINISHED FLOOR.

1
M04

8' 0' 8' 16'

SCALE: 1/8" = 1'-0"

SANITARY SEWER DEMOLITION, CONTROL WING BASEMENT

A	12/15/2008	ENGINEERING REVISION (R. ESTRADA) NX5			622533	12/08/2008	CR
REV	APPROVED DATE	DESCRIPTION			JCN	REDLINE DATE	APVD
DEPARTMENT OF TRANSPORTATION							
FEDERAL AVIATION ADMINISTRATION							
ATO - TECHNICAL OPERATIONS				EASTERN SERVICE AREA			
ARTCC							
STORM WATER PUMPS AND							
SEWER SYSTEM REPLACEMENT PROJECT							
CONTROL WING BASEMENT, DEMO							
HILLIARD		JACKSONVILLE CENTER				FL	
REVIEWED BY		SUBMITTED BY ORIGINAL SIGNED BY:			APPROVED BY ORIGINAL SIGNED BY:		
		Christopher G. Richard			Roberto Estrada,for		
		PROJECT ENGINEER			MGR: ENGINEERING - ATLANTA		
		DESIGNED	MO	ISSUED BY	DATE	JCN	622533
		DRAWN	DS	ENGINEERING SERVICES	06/26/2008		
		CHECKED		ENROUTE/FSS	DRAWING NO		
					ZJX-D-622533-M04		
					A		

ISSUED FOR FIELD REVISION